THIS DRAWING MUST NOT BE SCALED. • THE GENERAL CONTRACTOR SHALL VERIFY ALL DIMENSIONS, DATUMS AND LEVELS PRIOR TO COMMENCEMENT OF WORK. ALL ERRORS AND OMISSIONS TO BE REPORTED IMMEDIATELY TO THE ARCHITECT. • VARIATIONS & MODIFICATIONS TO WORK SHOWN ON THESE DRAWINGS SHALL NOT BE CARRIED OUT WITHOUT WRITTEN PERMISSION FROM THE ARCHITECT. • THIS DRAWING IS THE EXCLUSIVE PROPERTY OF THE ARCHITECTS AND CAN BE REPRODUCED ONLY WITH THE PERMISSION OF THE ARCHITECTS, IN WHICH CASE THE REPRODUCTION MUST BEAR THEIR NAME AS ARCHITECTS.

NE08

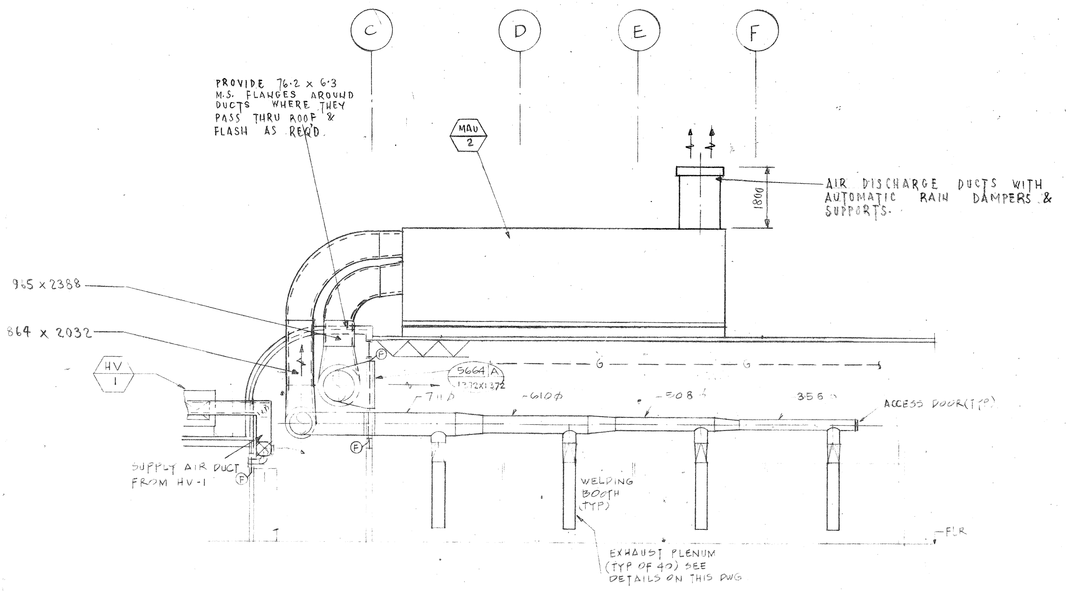

SECTION 1/M3
1/100

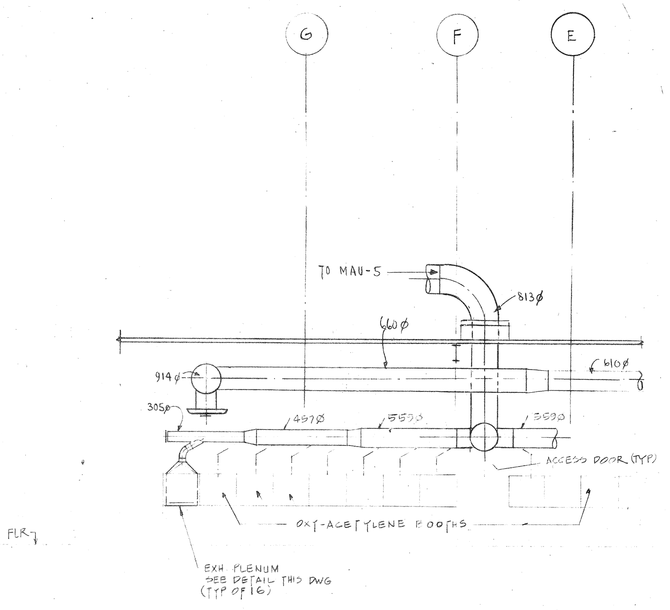

SECTION 2/M2
1/100

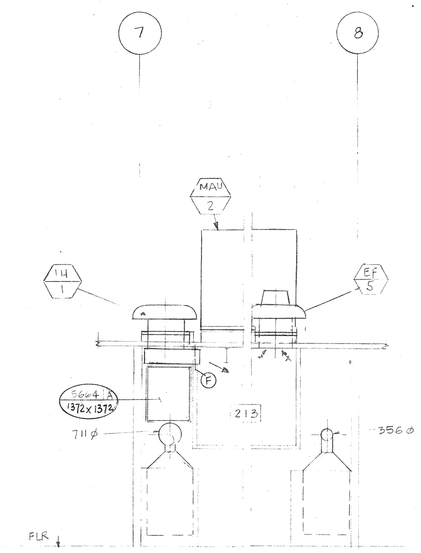

SECTION 3/M4
1/100

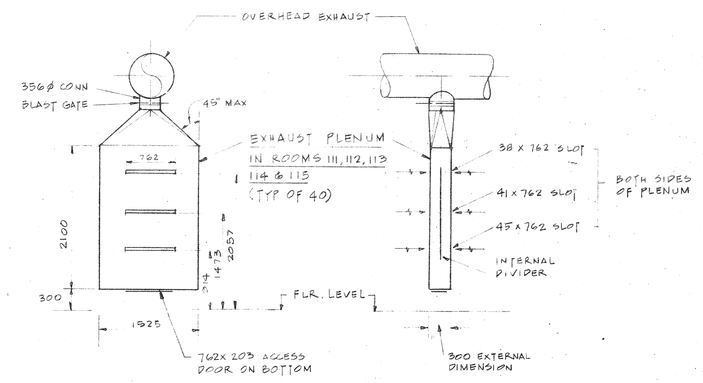

FRONT ELEVATION
1/50

SIDE ELEVATION
1/50

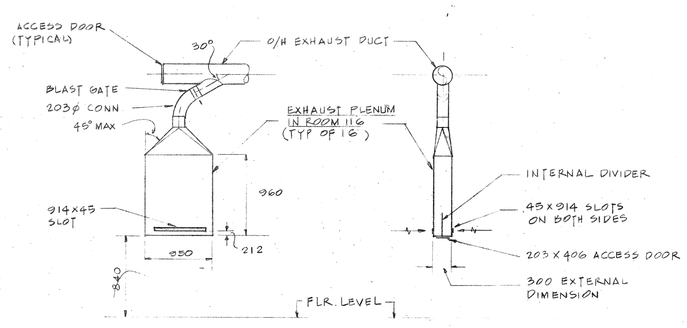

FRONT ELEVATION
1/50

SIDE ELEVATION
1/50

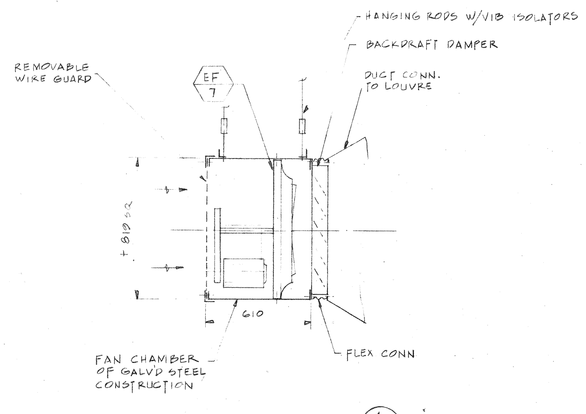

SECTION 4/M1
1/20

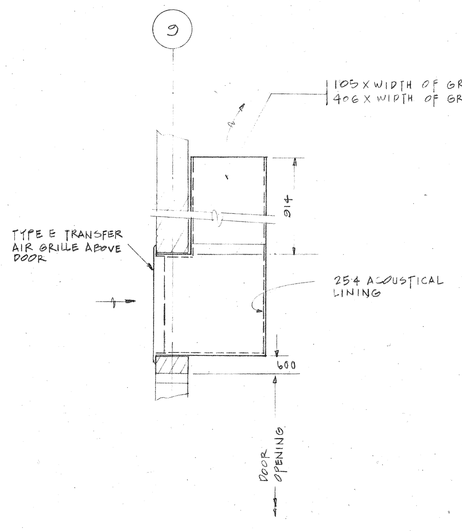

DETAIL OF DUCT ELBOW IN RMS 121 & 122
N.T.S.

NE08_1982-01_M4

NO.	DESCRIPTION	DATE	BY
	AS BUILT	03.05.31	AR
4.	REVISED AS PER POST TENDER ADD #1	82.06.01	AR
/	ISSUED FOR RETENDER	82.03.15	AR
3.	FINAL CO-ORDINATION.	82.03.12	AR
/	PRESENTED TO P.V.E	82.03.09	AR
2.	GENERAL REVISIONS.	82.01.09	AR
/	ISSUED FOR TENDER	82-01-04	AR
1.	GENERAL REVISIONS	82-01-04	AR
/	ISSUED FOR BUILDING PERMIT	81-12-23	SK

REVISIONS

WAISMAN DEWAR GROUT
ARCHITECTS AND PLANNERS
500 CARDERO STREET, ON THE WATER, VANCOUVER, B.C. V6G 2W6 687-8494

CONSULTANTS
ALAN REYNOLDS & CO. LTD.
CONSULTING MECHANICAL ENGINEERS
#28, 566 CARDERO ST,
VANCOUVER B.C. V6G 2W6
TELEPHONE 682-3187

PROJECT
PVI
welding training building
8114

SHEET TITLE
SECTIONS & DETAILS

SCALE: AS SHOWN
DRAWN: SK
DATE: 82-01-04
CHECKED:
SHEET NO.: M4

PROFESSIONAL ENGINEER PROVINCE OF BRITISH COLUMBIA

REVISION No.

SUPERCEDES ALL PRINTS BEARING PREVIOUS REVISION NUMBER

240303

BCL 6863E — W.D.G.

2.5