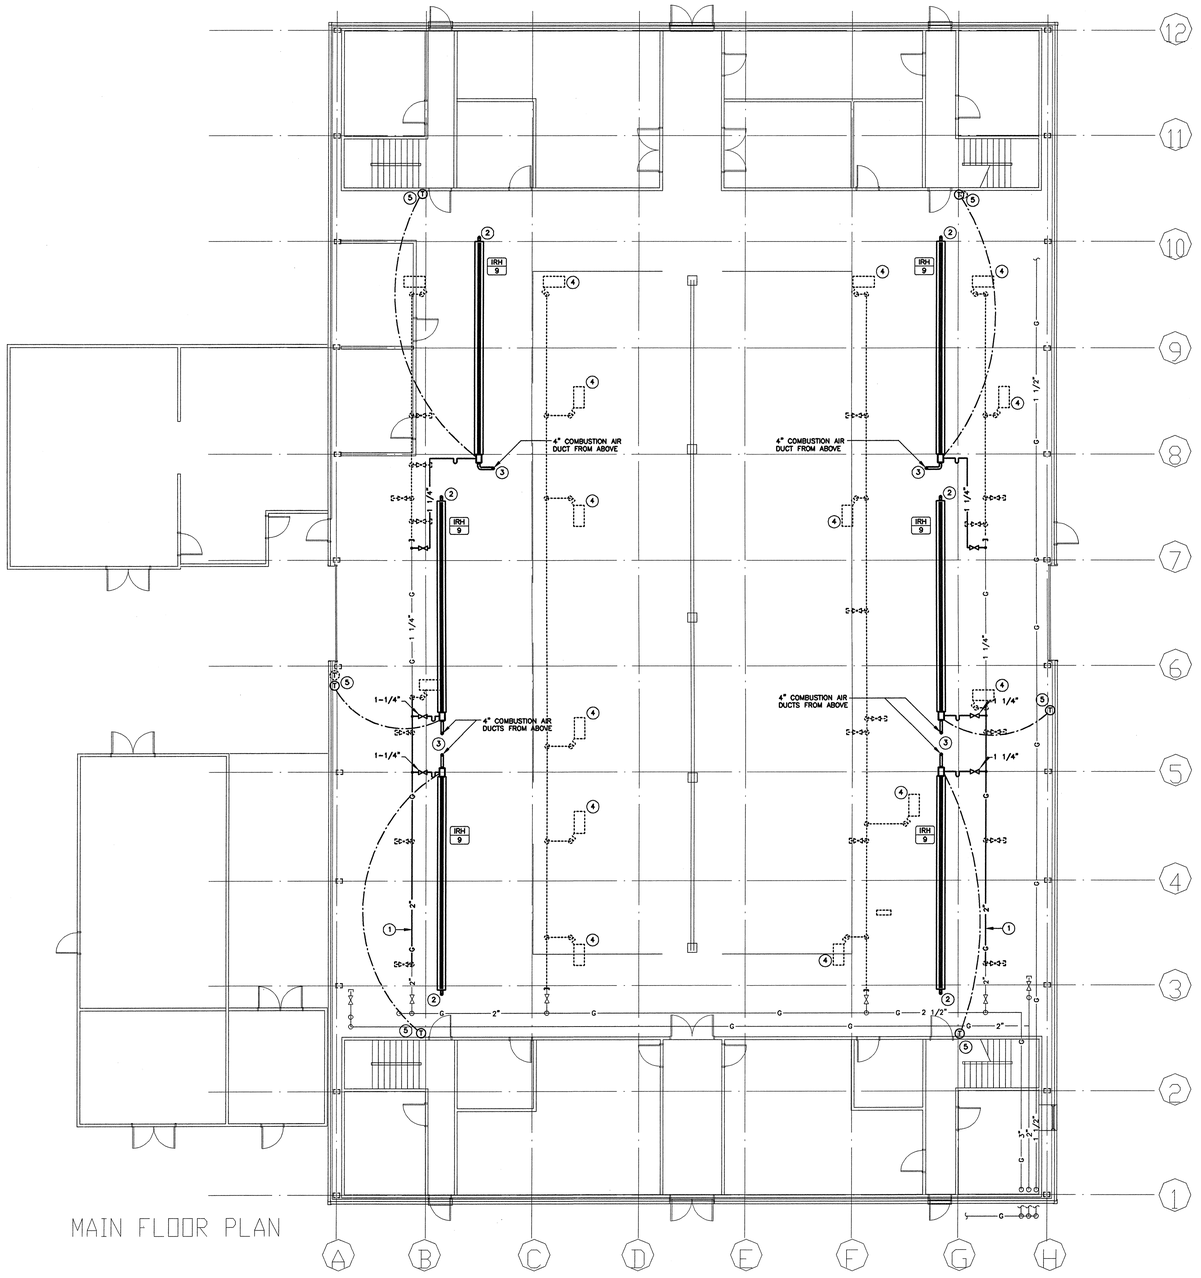

MAIN FLOOR PLAN

DRAWING NOTES :

1. REMOVE EXISTING 1-1/2" GAS PIPE AND EXTEND 2" GAS PIPE AS SHOWN.
2. VENT THROUGH ROOF AS PER DETAIL ON DRAWING M2. ROOFING BY APPROVED ROOFING CONTRACTOR (TYPICAL OF ALL).
3. COMBUSTION AIR DUCT THROUGH ROOF AS PER DETAIL ON DRAWING M2. ROOFING BY APPROVED ROOFING CONTRACTOR (TYPICAL OF ALL).
4. EXISTING PLATE GAS HEATERS (TYPICAL OF ALL) TO BE REMOVED c/w ASSOCIATED THERMOSTAT. REMOVE GAS PIPING AS SHOWN. CAP ENDS.
5. PROVIDE THERMAL BREAK BETWEEN THERMOSTAT AND WALL.

Stantec

Stantec Consulting Ltd.
100, 1985 W. Broadway
Vancouver BC Canada
V6J 4Y3
Tel. 604.742.8000
Fax. 604.742.8080
www.stantec.com

Copyright Reserved

The Contractor shall verify and be responsible for all dimensions. DO NOT scale the drawing – any errors or omissions shall be reported to Stantec without delay.
The Copyrights to all designs and drawings are the property of Stantec. Reproduction or use for any purpose other than that authorized by Stantec is forbidden.

NE06_2003-04_M1

"AS-BUILT"

Revision	By	Appd.	YY.MM.DD
A ISSUED FOR REVIEW	DN	BY	03.04.03
Issued	By	Appd.	YY.MM.DD
File Name: 15603054_M1.dwg	DN	BY	03.04.03
	Dwn.	Chkd.	Dsgn. YY.MM.DD

Permit-Seal

Client/Project
BCIT

INFRARED HEATERS

Burnaby BC Canada

Title
NE6
FLOOR PLAN

Project No. 15603054

Scale 1/8"=1' 0 8' 12' 16'

Drawing No. M1

Sheet 1 of 3

Revision A

ORIGINAL SHEET – ARCH D